

REPLACE ALL WINDOWS (2ND FLOOR)



1 NINTH STREET ELEVATION  
SCALE: 1/8" = 1'-0"


REPLACE ALL WINDOWS (2ND FLOOR)

REPLACE DOOR

REPLACE DOOR




2 MAIN STREET ELEVATION  
SCALE: 1/8" = 1'-0"

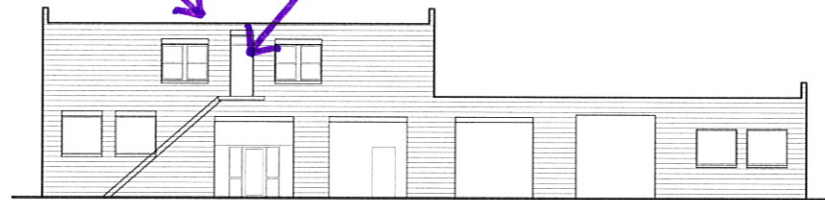

3 ALLEY ELEVATION  
SCALE: 1/8" = 1'-0"

REPLACE ALL 2ND FLOOR WINDOWS

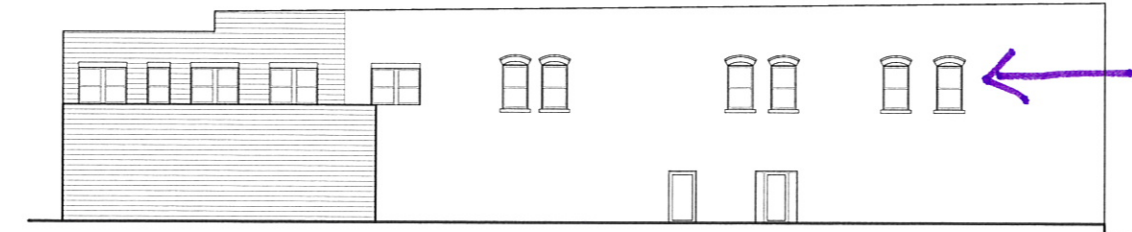

4 EAST ELEVATION  
SCALE: 1/8" = 1'-0"

# RAPID CITY GARAGE

Rapid City SD

PROJECT #1008  
STATUS As Built Drawings

## AcV2

1116 Ninth Street, Rapid City SD 57701  
(605) 484-6071




All drawings and material contained herein  
© 2011 AcV2 Architecture

ELEVATIONS

# A2.1

19 January 2011

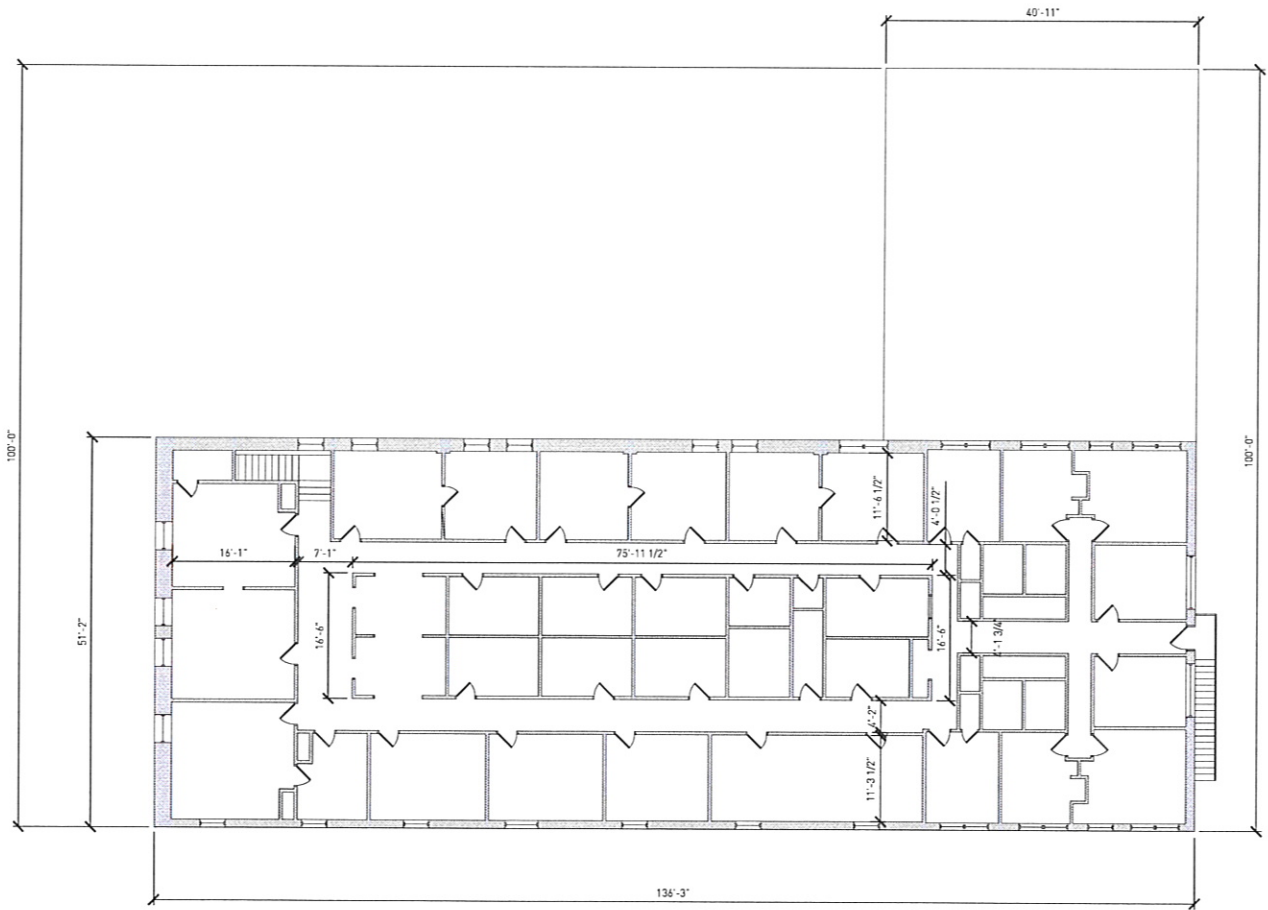

1 SECOND FLOOR: AS BUILT 

**RAPID CITY GARAGE**  
Rapid City SD

PROJECT #1008  
STATUS As Built Drawings

**AcV2**  
1116 Ninth Street, Rapid City SD 57701  
[605] 484-6071

PRELIMINARY  
NOT FOR CONSTRUCTION

All drawings and material contained herein  
© 2011 AcV2 Architecture

SECOND FLOOR:  
AS BUILT

**A1.2**

19 January 2011

PRELIMINARY

# CONCEPTUAL DESIGN #1

## HC GARAGE 2<sup>ND</sup> FLOOR

