


Taken from  
→ ORIGINAL PLAT  
Dated: 10/3/78

RECEIVED

APR - 7 2006

Rapid City Growth  
Management Department

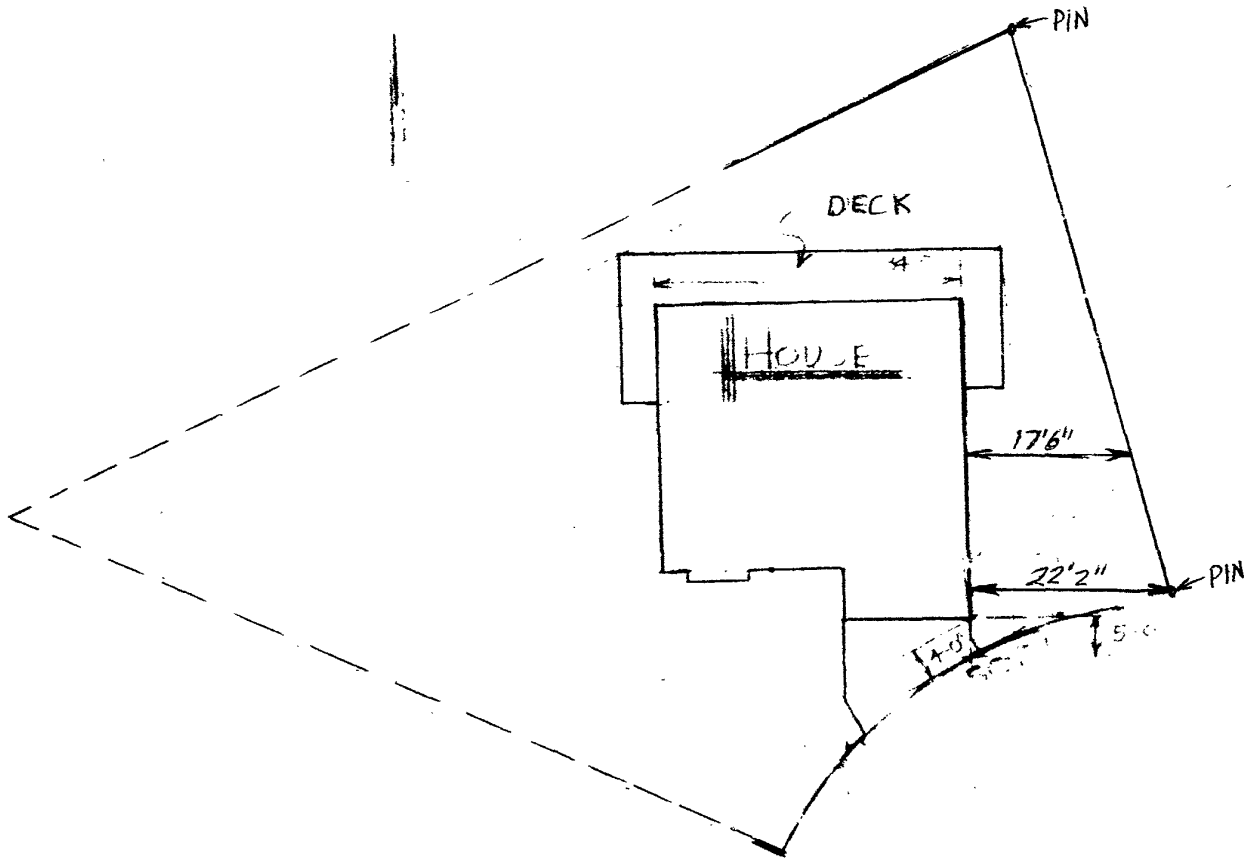


→ AS BUILT  
 SET BACKS  
 SURVEYS TAKEN  
 IN 2002

RECEIVED

APR - 7 2006

Rapid City Growth  
 Management Department

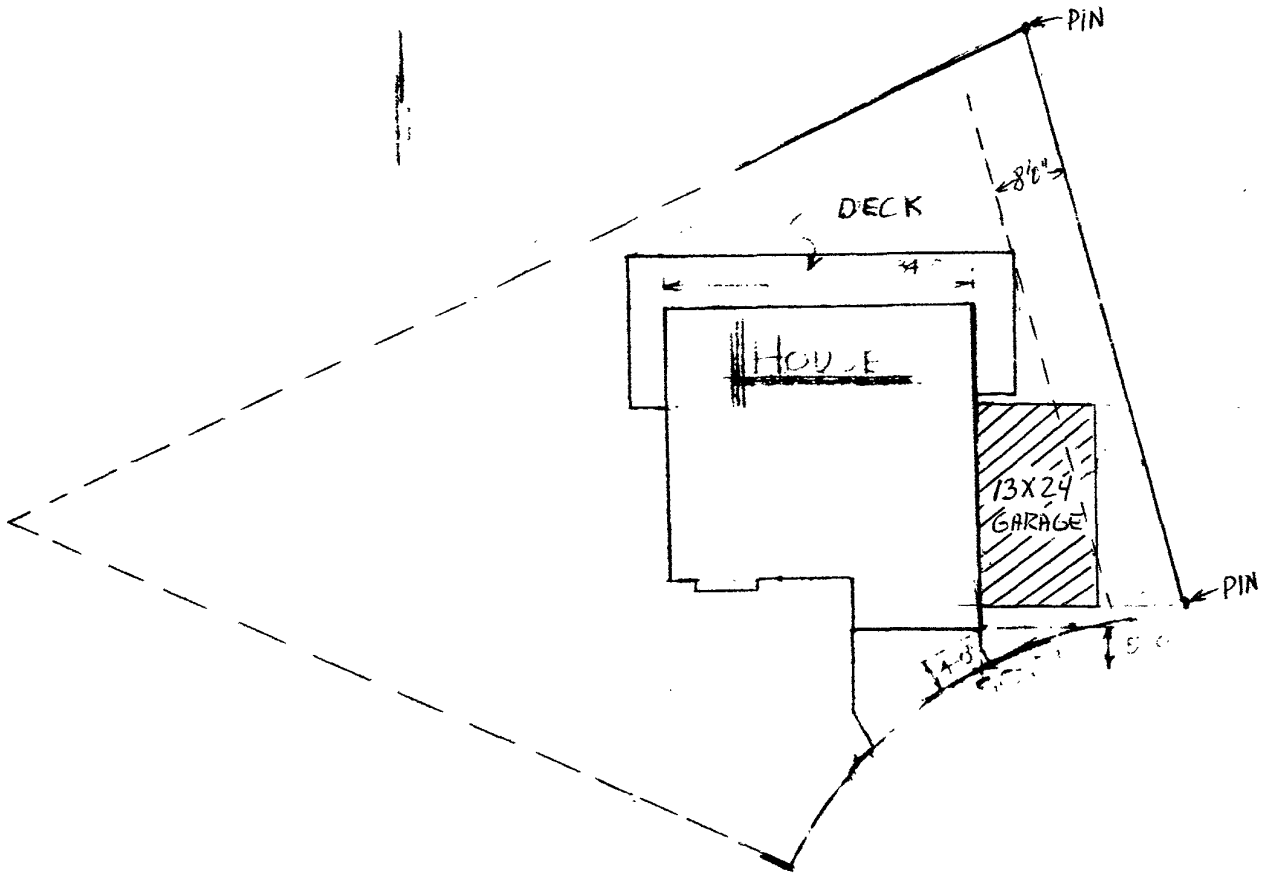

NEW GARAGE REQUEST

AS BUILT  
SET BACKS  
SURVEYS TAKEN  
IN 2002

RECEIVED

APR - 7 2006

Rapid City Growth  
Management Department