


PRD APPROVED DRIVEWAY LAYOUT

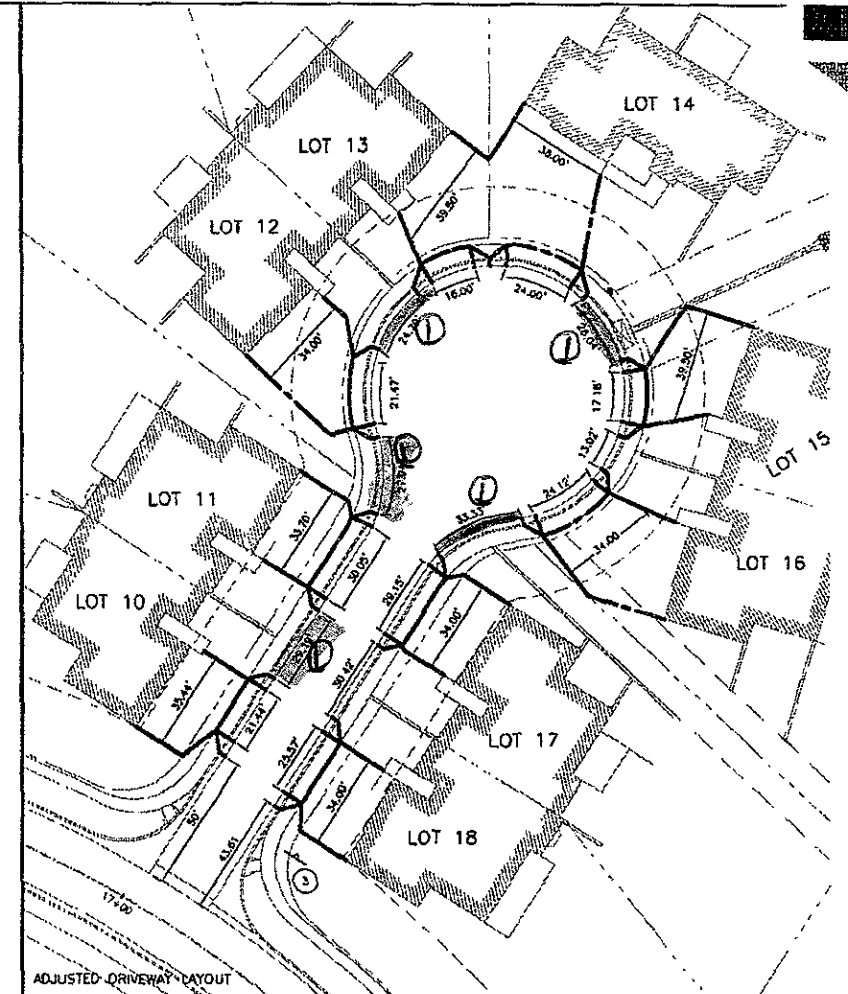


ADJUSTED DRIVEWAY LAYOUT

- ① 1 PARKING SPACE AVAILABLE.
- ② 2 PARKING SPACE AVAILABLE.
- ③ INSTALL SIGN: NO PARKING THIS SIDE OF STREET

LEGEND
 ——— PRD APPROVED DESIGN DRIVEWAY LOCATION.
 ——— ADJUSTED DRIVEWAY LOCATIONS

PRELIMINARY
NOT FOR CONSTRUCTION

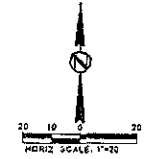

TOWER COURT
 TOWER RD RECONSTRUCTION PROJECT
 JOB NUMBER: 071231001
 DATE: 07/28/09

517 7th street rapid city sd 57101
 ph 605 342 9120 fax 605 372 2377
 www.dhainbse
 ARCHITECTURE ENGINEERING
 DESIGN INC
 CIVIL SURVEYING

NO.	DATE	REVISIONS

ASBUILT
 DRIVEWAY
 AND ON
 STREET PARKING
 SHEET
 1

FILE: 1371-601-TOWERCT-STRGSS.DWG. PRINT DATE: 2/12/2009 5:07:24 PM

NO PART OF THIS DOCUMENT MAY BE REPRODUCED OR TRANSMITTED IN ANY FORM OR BY ANY MEANS WITHOUT PERMISSION FROM FERRACORP. DESIGN INC.